


Národní hřebčín Kladruby, 533 14 Kladruby nad Labem  
obj.č.19.: bytový dům č.p. 48 na pozemku parc.č.33/1

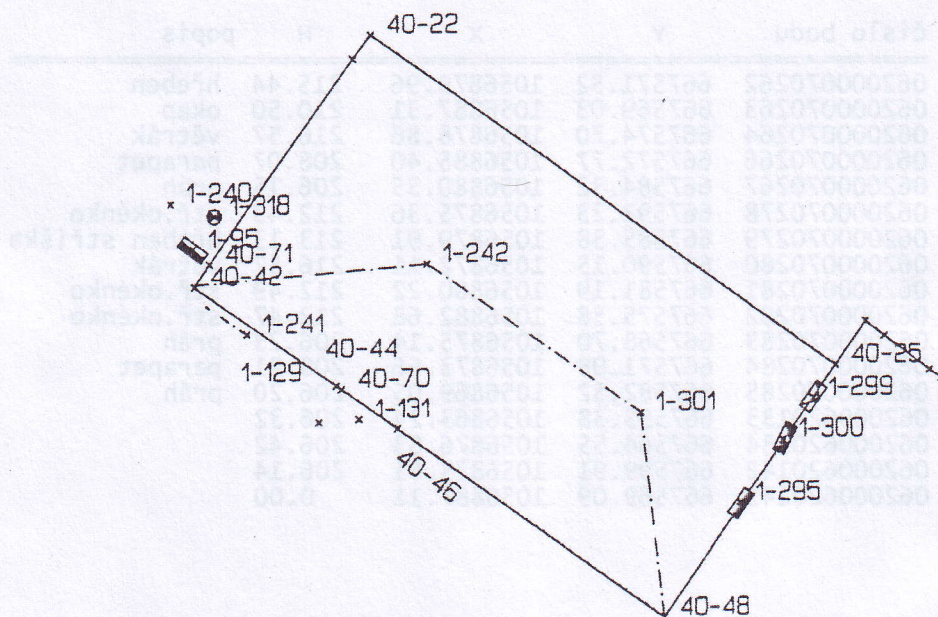

CP48.txt

SEZNAM SOUŘADNIC A VÝŠEK				
ČÍSLO BODU	Y	X	H	POPIS
062000010095	667692.00	1056119.25	207.64	práh
062000010129	667684.73	1056129.24	209.85	okno chodba par.
062000010131	667682.46	1056129.09	212.71	hřeben
062000010240	667693.28	1056116.68	221.92	"
062000010241	667688.86	1056124.17	216.37	okap
062000010242	667678.55	1056120.19	223.54	hřeben
062000010295	667660.33	1056133.98	207.55	vchod
062000010299	667656.09	1056128.08	208.77	
062000010300	667657.83	1056130.43	213.54	parapet 1.p
062000010301	667666.18	1056128.84	223.55	hřeben
062000010318	667690.74	1056117.39	213.57	
062000400020	667651.94	1056124.54	0.00	
062000400022	667681.78	1056107.14	0.00	
062000400025	667654.78	1056126.21	207.41	
062000400042	667691.89	1056121.43	207.50	
062000400044	667683.74	1056127.17	0.00	
062000400046	667680.26	1056129.62	0.00	
062000400048	667664.81	1056140.51	207.39	
062000400069	667682.80	1056108.53	0.00	
062000400070	667683.45	1056127.38	207.51	
062000400071	667691.02	1056120.11	0.00	
062000400081	667653.02	1056123.70	0.00	
062001280197	667648.58	1056126.99	0.00	
062001280317	667649.30	1056126.51	0.00	