


Národní hřebčín Kladruby, 533 14 Kladruby nad Labem
obj.č.14.: bytový dům č.p. 44. na pozemku parcel.číslo 28

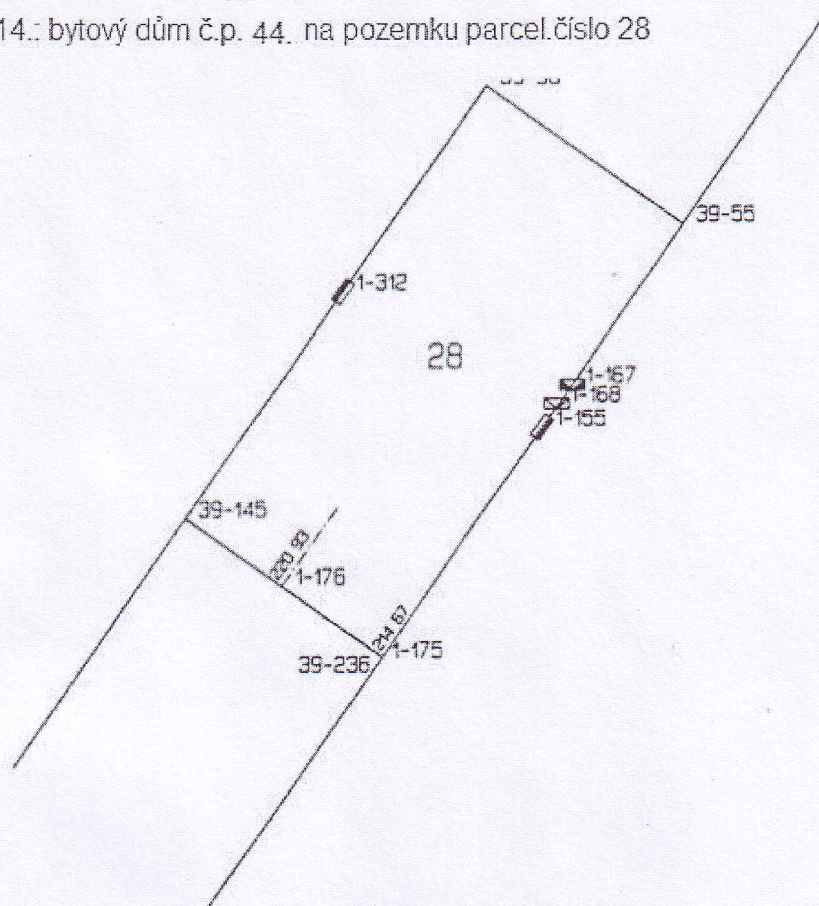

SEZNAM SOUŘADNIC A VÝŠEK


| Číslo bodu | Y | X | H | Popis |
|--------------|-----------|------------|--------|---------------|
| 062000010155 | 667781.97 | 1056050.00 | 207.41 | práh |
| 062000010163 | 667789.74 | 1056061.08 | 209.36 | parapet |
| 062000010165 | 667792.36 | 1056062.21 | 213.44 | stř.okénko |
| 062000010167 | 667780.54 | 1056047.96 | 208.26 | parapet |
| 062000010168 | 667781.27 | 1056048.86 | 212.10 | parapet patro |
| 062000010175 | 667789.45 | 1056060.83 | 214.67 | okap |
| 062000010176 | 667794.36 | 1056057.47 | 220.93 | hřeben |
| 062000010312 | 667791.52 | 1056043.62 | 207.42 | práh |
| 062000390055 | 667775.28 | 1056040.45 | 207.22 | |
| 062000390090 | 667784.73 | 1056033.89 | 207.30 | |
| 062000390145 | 667798.98 | 1056054.32 | 207.28 | |
| 062000390236 | 667789.48 | 1056060.82 | 207.14 | |

Národní hřebčín Kladruby , 533 14 Kladruby nad Labem

obj.č.14.: nízké stáje na pozemku parcel.číslo 29

Staje na cp.29

| SEZNAM SOUŘADNIC | | | | výškový systém: Bpv | |
|-----------------------------|---------------|---------------|---------------|---------------------|-------|
| Souřadnicový systém: S-JTSK | | | | | |
| == ČÍSLO BODU == | ===== Y ===== | ===== X ===== | ===== Z ===== | POPIS | ===== |
| 062000010157 | 667791.47 | 1056063.62 | 207.28 | práh | |
| 062000010158 | 667793.84 | 1056067.00 | 207.29 | " | |
| 062000010159 | 667796.18 | 1056070.41 | 207.29 | " | |
| 062000010160 | 667800.70 | 1056076.88 | 207.26 | " | |
| 062000010161 | 667804.71 | 1056082.54 | 207.40 | " | |
| 062000010162 | 667810.92 | 1056091.53 | 207.31 | " | |
| 062000010163 | 667789.74 | 1056061.08 | 209.36 | parapet | |
| 062000010164 | 667790.80 | 1056063.41 | 211.21 | okap | |
| 062000010165 | 667792.36 | 1056062.21 | 213.44 | stř.okénko | |
| 062000010166 | 667795.90 | 1056060.03 | 217.04 | hřeben | |
| 062000010167 | 667780.54 | 1056047.96 | 208.26 | parapet | |
| 062000010168 | 667781.27 | 1056048.86 | 212.10 | parapet patro | |
| 062000010169 | 667812.02 | 1056092.95 | 207.33 | práh | |
| 062000010170 | 667816.13 | 1056098.95 | 207.36 | " | |
| 062000010171 | 667818.48 | 1056102.25 | 207.26 | " | |
| 062000010304 | 667827.85 | 1056095.72 | 207.26 | | |
| 062000010305 | 667825.53 | 1056092.40 | 207.17 | | |
| 062000010306 | 667821.37 | 1056086.43 | 207.16 | | |
| 062000010307 | 667819.91 | 1056084.34 | 207.26 | práh | |
| 062000010308 | 667818.28 | 1056082.00 | 207.23 | práh | |
| 062000010309 | 667805.54 | 1056063.73 | 207.24 | | |
| 062000010310 | 667803.24 | 1056060.43 | 207.27 | | |
| 062000010311 | 667801.10 | 1056057.36 | 207.27 | | |
| 062000390144 | 667822.85 | 1056108.68 | 207.28 | | |
| 062000390145 | 667798.98 | 1056054.32 | 207.28 | | |
| 062000390146 | 667832.31 | 1056102.12 | 207.25 | | |
| 062000390236 | 667789.48 | 1056060.82 | 207.14 | | |

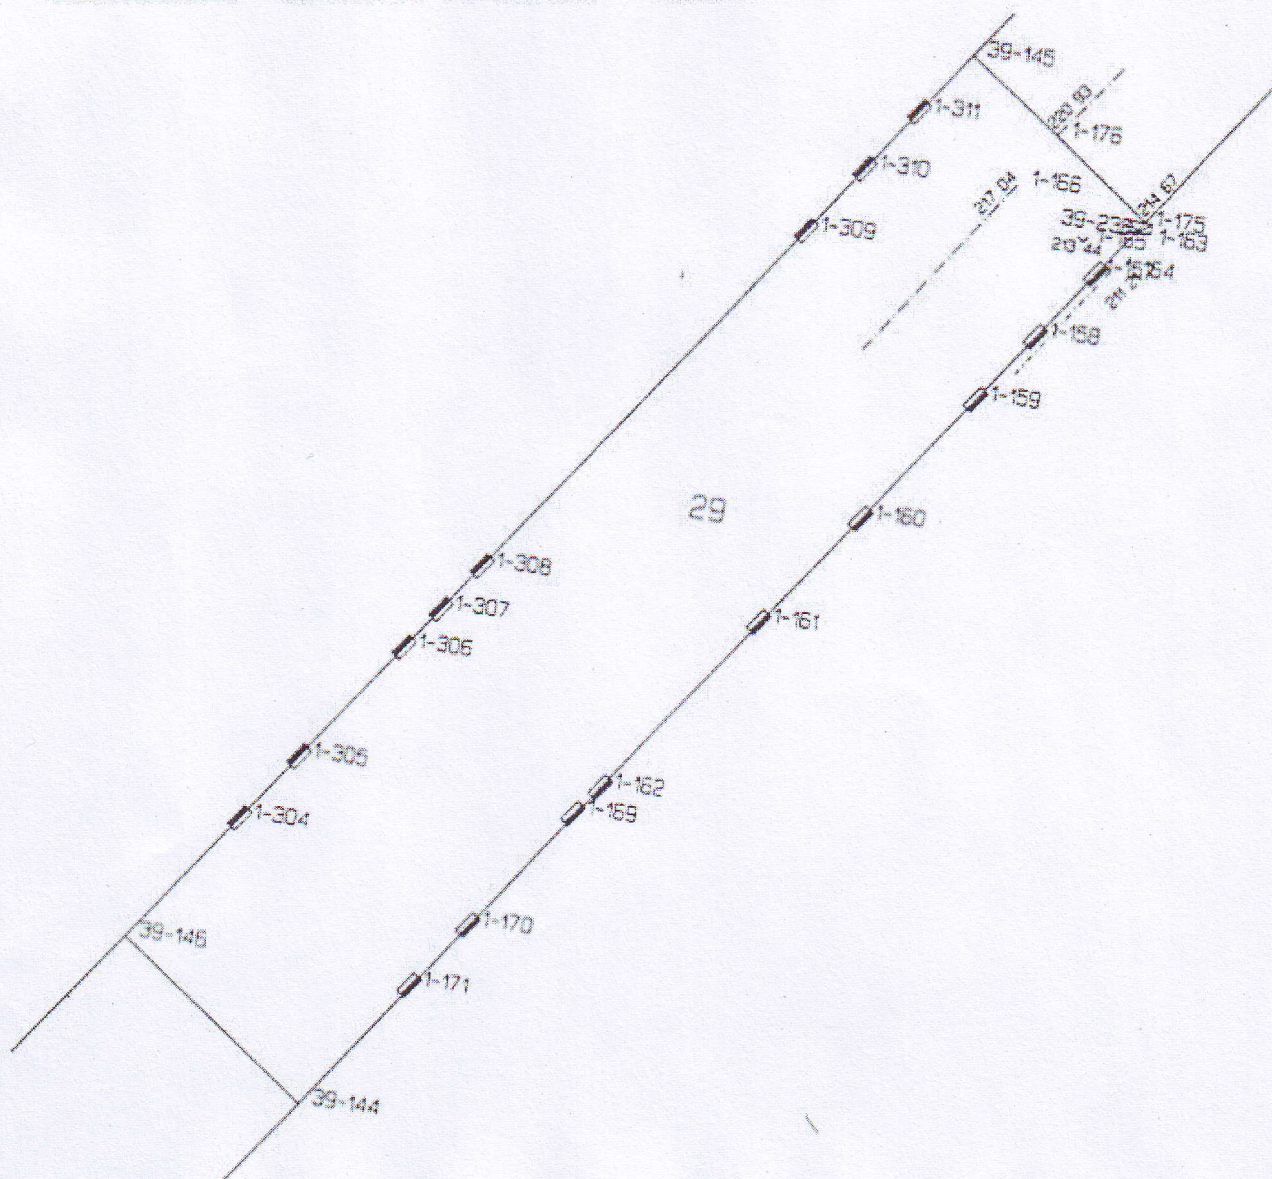

Národní hřebčín Kladruby , 533 14 Kladruby nad Labem
obj.č.14.: bytový dům č.p.46 na pozemku parcelní číslo 30

parc.č.30

| S E Z N A M S O U Ř A D N I C | | | | Výškový systém: Bpv |
|---------------------------------|---------------|------------|---------|---------------------|
| Souřadnicový systém: S-JTSK | | | | |
| = ČÍSLO BODU | ===== Y ===== | X ===== | Z ===== | POPIS ===== |
| 062000010173 | 667829.53 | 1056118.28 | 207.43 | práh |
| 062000010177 | 667834.64 | 1056125.55 | 208.35 | parapet |
| 062000010178 | 667834.65 | 1056125.52 | 212.23 | parapet patro |
| 062000010228 | 667829.64 | 1056119.22 | 214.71 | okap |
| 062000010229 | 667838.65 | 1056121.35 | 220.62 | hřeben |
| 062000010303 | 667838.98 | 1056111.69 | 207.41 | práh |
| 062000010332 | 667828.26 | 1056114.87 | 216.94 | stř.okénko |
| 062000390037 | 667837.06 | 1056129.06 | 207.08 | body KU |
| 062000390061 | 667846.52 | 1056122.50 | 207.25 | |
| 062000390144 | 667822.85 | 1056108.68 | 207.28 | |
| 062000390146 | 667832.31 | 1056102.12 | 207.25 | |

